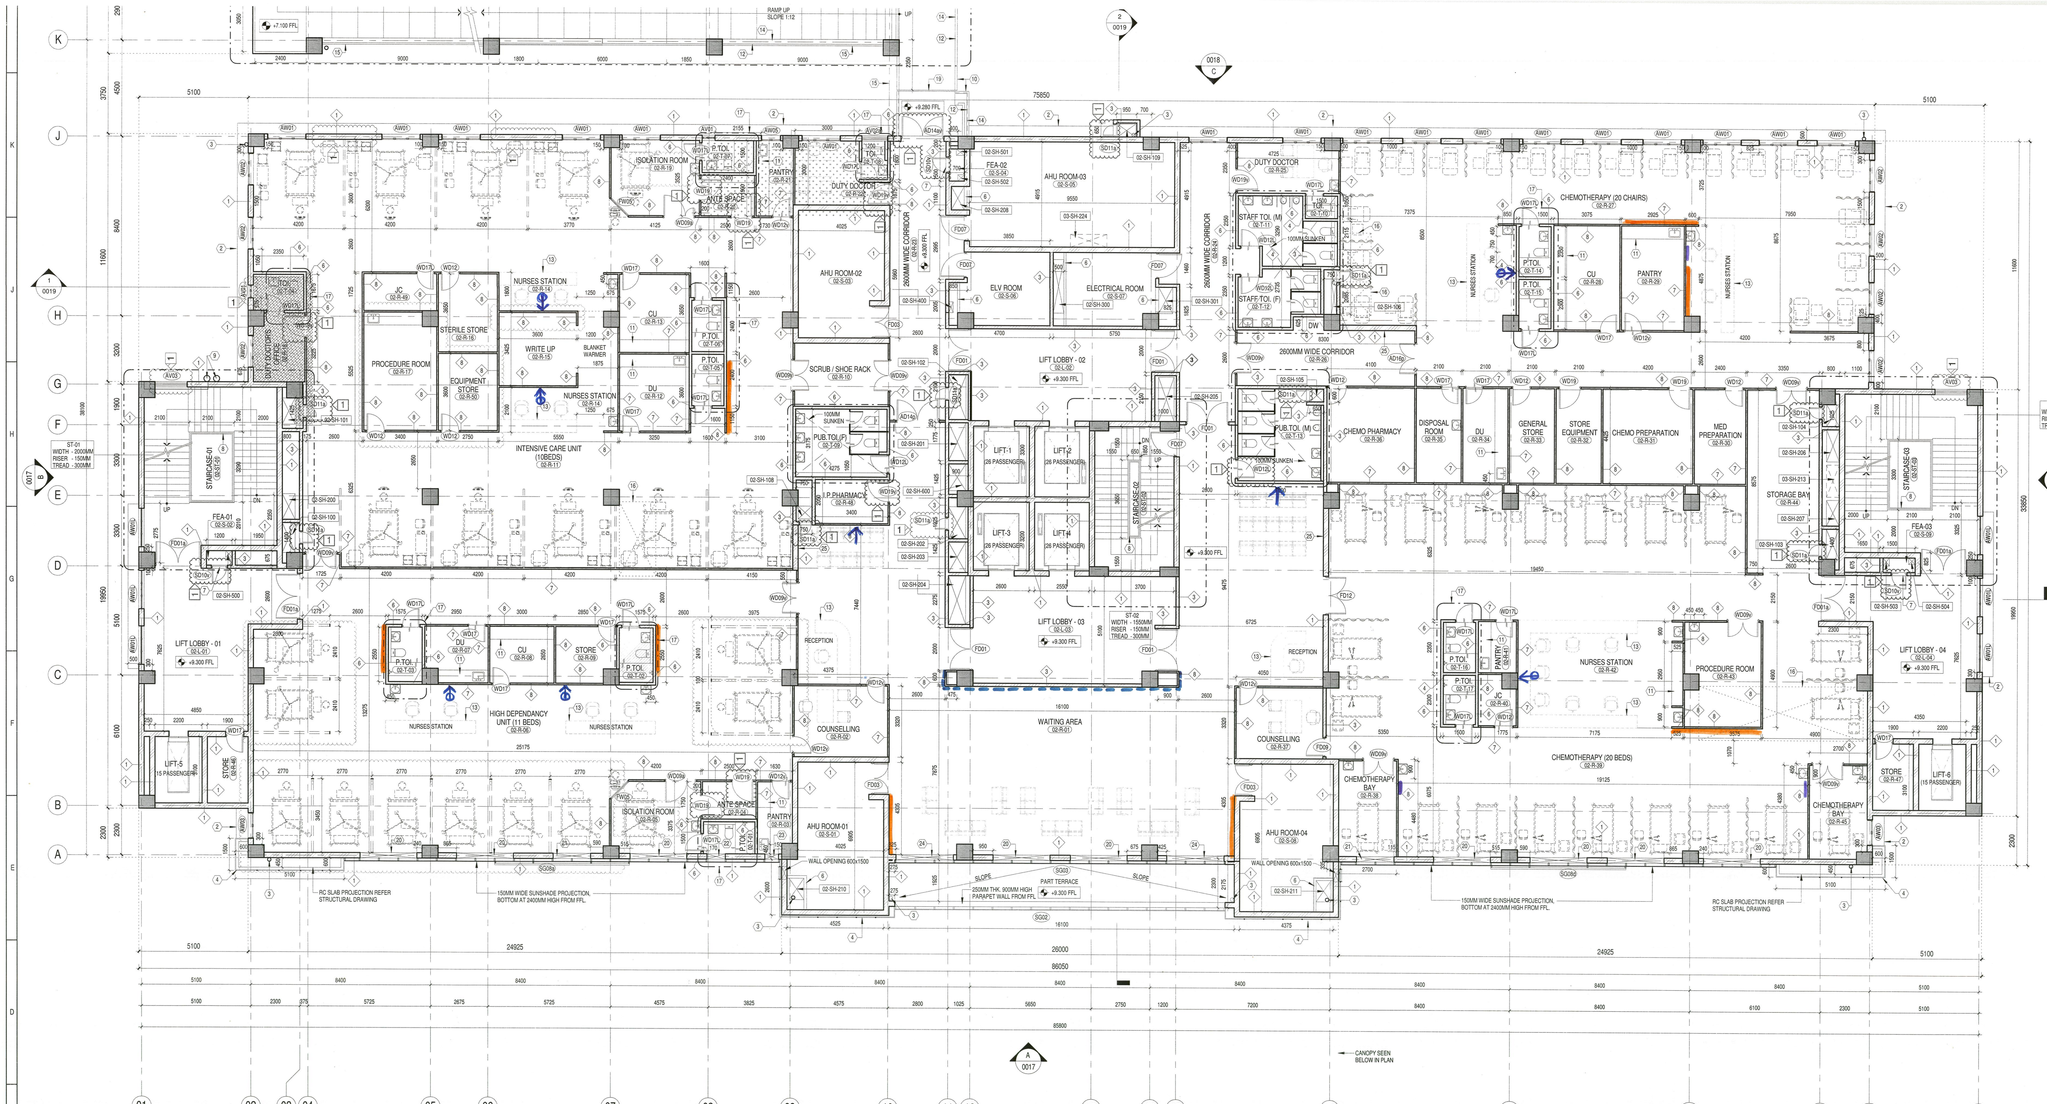

SECOND FLOOR PLAN

SCALE - 1 : 100

GENERAL NOTES :

01. ALL DIMENSIONS ARE IN MILLIMETERS & LEVELS IN METERS.
02. +0.000FFL REFERS TO 49.450 LEVEL AT SITE.
03. THIS DRAWING SHOULD BE READ IN CONJUNCTION WITH THE ALL FLOOR PLANS, ELEVATIONS & SECTIONS O19035-A-HP-04-WD-0009 TO 0020.
04. JOINERY / STRUCTURAL GLAZING SHOWN IN PLAN ARE INDICATIVE, REFER HARDWARE SCHEDULE TEMPLATE FOR DETAILS.
05. FOR JOINERY, STAIRCASE, RAMP DETAILS, LIFTS, TOILETS, WALL SECTIONS, FLOORING PATTERN DETAILS, FURNITURE LAYOUTS & FALSE CEILING DETAILS REFER SEPARATE DRAWINGS.
06. FOR STRUCTURAL, PUBLIC HEALTH ENGINEERING, HVAC, ELECTRICAL, AND FIRE FIGHTING DETAILS REFER APPROPRIATE SEPARATE DRAWINGS.
07. AHU PEDESTAL DETAIL REFER STRUCTURAL DRAWING.

FLOOR LEVEL — ROOM SERIAL NO. — ROOM TYPE

ROOM TAG KEYNOTE:

S - SERVICES
T - TOILET
L - LIFT LOBBY
ST - STAIRCASE
R - ROOMS

FLOOR LEVEL — SHAFT TYPE / SERIAL NO. — SHAFT

SHAFT NO	SHAFT TYPE
1XX	PHE
2XX	HVAC
3XX	ELECTRICAL
4XX	ELV
5XX	FEA
6XX	MGPS

SUNKEN LEGEND:

FLOOR SLAB TO BE SUNKEN BY 250MM FROM TOC
FLOOR SLAB TO BE SUNKEN BY 300MM FROM TOC

CUTOUT LEGEND:

FLOOR CUTOUT
ROOF CUTOUT

SHAFT SCHEDULE - SECOND FLOOR

TAG	DESCRIPTION	LENGTH	WIDTH
02-SH-100	PHE SHAFT	600	1400
02-SH-101	PHE SHAFT	600	1225
02-SH-102	PHE SHAFT	800	2075
02-SH-103	PHE SHAFT	600	1400
02-SH-104	PHE SHAFT	600	1025
02-SH-105	PHE SHAFT	650	600
02-SH-106	PHE SHAFT	250	1525
02-SH-108	PHE SHAFT	650	600
02-SH-109	PHE SHAFT	850	600
02-SH-200	HVAC SHAFT	600	1200
02-SH-201	HVAC SHAFT	600	1200
02-SH-202	HVAC SHAFT	800	1775

DOOR SCHEDULE - SECOND FLOOR

TAG	WIDTH	HEIGHT	COUNT
AD14av	2000	2400	1
AD14p	2000	2100	1
AD16p	1500	2100	1
FD01	2000	2100	5
FD01a	2150	2100	4
FD03	1500	2100	3
FD07	1200	2100	4
FD09	900	2100	1
FD12	1800	2100	1
SD10x	700	2000	3
SD11a	600	1500	10
WD09a	1500	2100	2
WD09v	1500	2100	9

WINDOW / LOUVER SCHEDULE -...

TAG	WIDTH	HEIGHT	COUNT
AW01	600	600	2
AW02a	1200	450	1
AW03	1500	600	2
AW01	1800	1000	17
AW01L	1800	1500	6
AW02	1500	1500	7
AW03	1200	1500	2
AW05	900	1500	1
EAL06	900	300	1
EAL07	300	300	2
FAL05	1250	600	1
FAL07	1000	250	1

STENCIL PAINT- TYPE-3
STENCIL PAINT- TYPE-1 (VERTICAL)
ARTWORK
ARTWORK - 2 (BAMBOO)
WALL ART / INSTALLATION

KEY PLAN
SCALE - NTS

KEY NOTES :

1. 1500x600 WALL OPENING AT SILL 1150MM FROM FINISHED MID LANDING LEVEL.
2. 500MM WIDE SUNSHADE ABOVE.
3. RAIN WATER DOWN TAKE PIPE.
4. ACP CLADDING.
5. 1800x1500 WALL OPENING AT SILL 900MM FROM FINISHED FLOOR LEVEL.
6. 100MM THK. 100MM HIGH RC KERB WALL FROM FFL. (REFER STRUCTURAL DRAWING).
7. FEA SHAFT DOOR 100MM SILL FROM FINISH FLOOR LEVEL.
8. M.S HANDRAIL TO DETAIL.
9. OG SMOKE EXHAUST PIPE UP TO TERRACE.
10. CONNECTING CORRIDOR ABOVE.
11. COUNTER TO DETAIL.
12. RC DROP REFER STRUCTURAL DRAWING.
13. RECEPTION / NURSES TABLE.
14. RC PARAPET WALL.
15. RC BEAM SEEN IN PLAN.
16. ROOF SLAB TO BE SUNKEN.
17. REFER STAIRADED DRAWING FOR TOILET DETAILS.
18. 1500x600 WALL OPENING AT SILL 250MM FROM FINISHED MID LANDING LEVEL.
19. EXPANSION JOINT REFER STRUCTURAL DRAWING.
20. 2650x1500MM WALL OPENING 900 SILL FROM FINISHED FLOOR LEVEL.
21. 1750x1500MM WALL OPENING 900 SILL FROM FINISHED FLOOR LEVEL.
22. 850x1500MM WALL OPENING 900 SILL FROM FINISHED FLOOR LEVEL.
23. 640x1500MM WALL OPENING 900 SILL FROM FINISHED FLOOR LEVEL.
24. 2675x1500MM WALL OPENING 900 SILL FROM FINISHED FLOOR LEVEL.
25. DB LOCATION.
— 10MM DROP FROM FINISH FLOOR LEVEL.

REVISION HISTORY - 1:

1. ELECTRICAL ROOM LAYOUT REVISED AS PER CLIENT REQUIREMENT TO GET ADDITIONAL SPACE FOR FUTURE TRANSFORMER. CON No: O19035-A-HP-CE-0006
2. REFER O19035-A-HP-CE-0011 FOR CHANGES TO ALIGN AS PER INTERIOR SCHEMES, AND CHANGES AS PER REQUIREMENTS IN HOSPITAL BLOCK. OTHER CHANGES IN HVAC LOUVERS.

CLIENT SIGNATURE :

REV.NO.	DESCRIPTION	DESIGNED	DRAWN	CHECKED	APPROVED
1	REVISED AS PER REVISION HISTORY-1 & RELEASED AS GOOD FOR CONSTRUCTION	ARKH 12.01.2021	TJR 12.01.2021	TI 27.02.2021	JA 27.02.2021
0	RELEASED AS GOOD FOR CONSTRUCTION	ARKH 11.10.2019	TJR 14.10.2019	TI 16.10.2019	JA 16.10.2019

REVISIONS

CHECKED BY	SIGN	DATE	CHECKED BY	SIGN	DATE	CHECKED BY	SIGN	DATE
ARCHITECTURE			HVAC			GIS		
CIVIL & STRUCTURAL			FPS			GEOTECH		
ELECTRICAL			PIPING			VHT		
ELV SYSTEM			PHE					

CLIENT : ASSAM CANCER CARE

L&T Construction