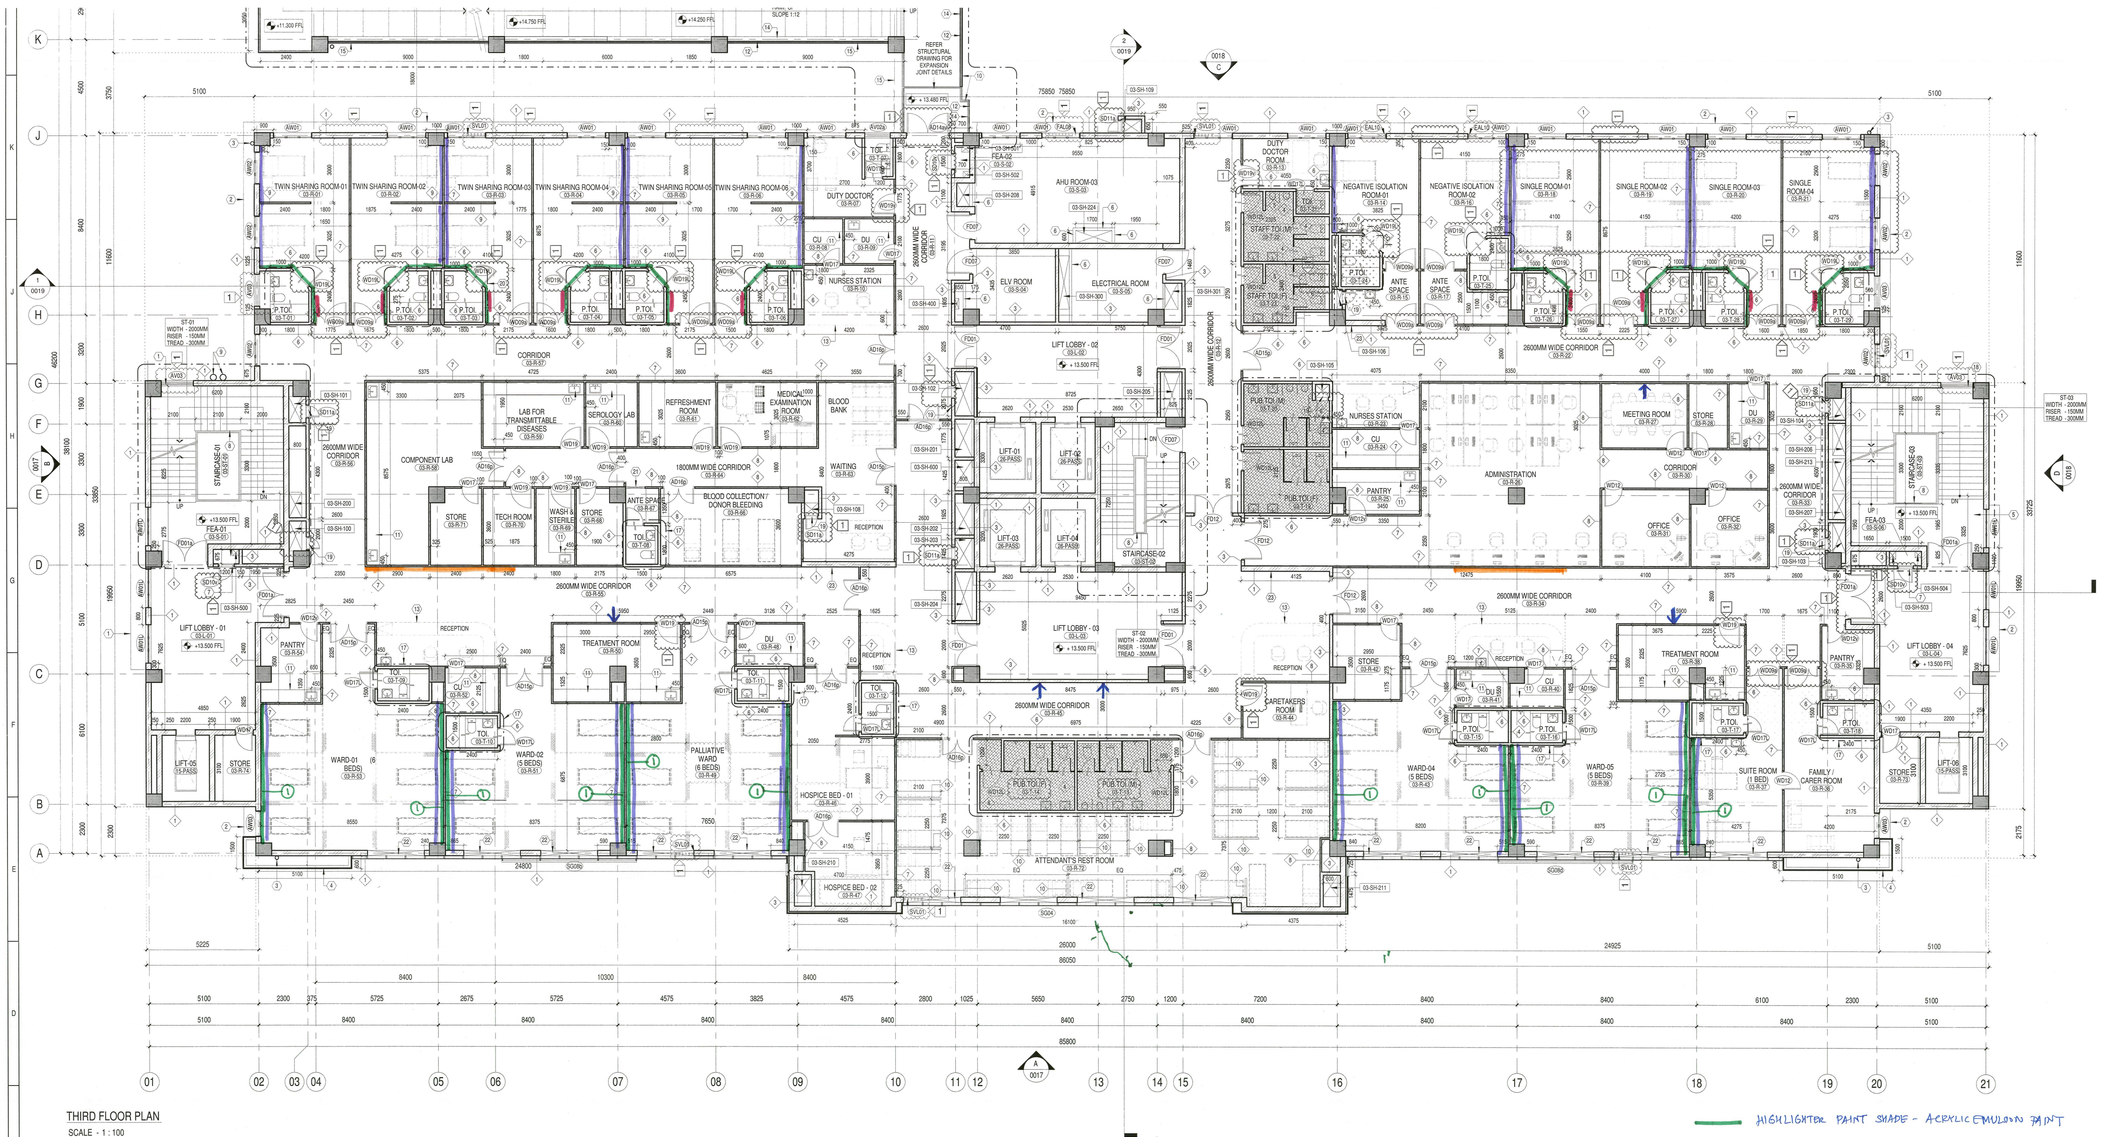

THIRD FLOOR PLAN

SCALE - 1 : 100

HIGHLIGHTER PAINT SHADE - ACRYLIC EMULSION PAINT

" " UPTO 1220MM FROM THE FFL.

STENCIL PAINT TYPE -1.

ARTWORK

STENCIL PAINT TYPE - 2

STENCIL PAINT TYPE - 3

KEY PLAN

SCALE - NTS

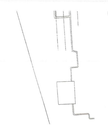

KEY NOTES :

1. 1550x600 WALL OPENING AT SILL 1150MM FROM FINISHED MID LANDING LEVEL.
2. 500MM WIDE SUNSHADE ABOVE.
3. RAIN WATER DOWN TAKE PIPE.
4. ACP CLADDING.
5. 1100x1500 WALL OPENING AT SILL 900MM FROM FINISHED FLOOR LEVEL.
6. 100MM THK. 100MM HIGH RC KERB WALL FROM FFL. (REFER STRUCTURAL DRAWING).
7. FEA SHAFT DOOR 100MM SILL FROM FINISH FLOOR LEVEL.
8. M.S.HANDRAIL TO DETAIL.
9. DG SMOKE EXHAUST PIPE UP TO TERRACE.
10. CONNECTING CORRIDOR ABOVE.
11. COUNTER TO DETAIL.
12. RC DROP REFER STRUCTURAL DRAWING.
13. RECEPTION / NURSES TABLE.
14. RC PARAPET WALL.
15. RC BEAM SEEN IN PLAN.
16. ROOF SLAB TO BE SUNKEN.
17. REFER STAIRAEDS DRAWING FOR TOILET DETAILS.
18. 1500x600 WALL OPENING AT SILL 2550MM FROM FINISHED MID LANDING LEVEL.
19. PHE SHAFT DOOR 100MM SILL FROM FINISH FLOOR LEVEL.
20. REFER SEPARATE DRAWING FOR TOILET DETAILS.
21. 900x2100 WALL OPENING FROM FINISHED FLOOR LEVEL.
22. 2650x1500MM WALL OPENING 900 SILL FROM FINISHED FLOOR LEVEL.
23. ELECTRICAL DB LOCATION.

~ 10MM DROP FROM FINISH FLOOR LEVEL.

REVISION HISTORY - 1:

1. ELECTRICAL ROOM LAYOUT REVISED AS PER CLIENT REQUIREMENT TO GET ADDITIONAL SPACE FOR FUTURE TRANSFORMER. CCN No: O19035-A-HP-CE-0006
2. REFER O19035-A-HP-CE-0011 FOR CHANGES TO ALIGN AS PER INTERIOR SCHEMES, AND CHANGES AS PER REQUIREMENTS IN HOSPITAL BLOCK. OTHER CHANGES IN HVAC LOUVERS.

CLIENT SIGNATURE :

REV.NO.	DESCRIPTION	DESIGNED	DRAWN	CHECKED	APPROVED
1	REVISED AS PER REVISION HISTORY-1 & RELEASED AS GOOD FOR CONSTRUCTION.	ARKH 13.01.2021	TJR 13.01.2021	TI 27.02.2021	JA 27.02.2021
0	RELEASED AS GOOD FOR CONSTRUCTION	ARKH 08.10.2019	MG 12.10.2019	TI 16.10.2019	JA 16.10.2019

REVISIONS

CHECKED BY	SIGN	DATE	CHECKED BY	SIGN	DATE	CHECKED BY	SIGN	DATE
ARCHITECTURE			HVAC			GIS		
CIVIL & STRUCTURAL			FPS			GEOTECH		
ELECTRICAL			PIPING			VHT		
ELV SYSTEM			PHE					

CLIENT : ASSAM CANCER CARE

L&T Construction

GENERAL NOTES :

01. ALL DIMENSIONS ARE IN MILLIMETERS & LEVELS IN METERS.
02. +0.000FFL REFERS TO 49.450 LEVEL AT SITE.
03. THIS DRAWING SHOULD BE READ IN CONJUNCTION WITH THE ALL FLOOR PLANS, ELEVATIONS & SECTIONS O19035-A-HP-04-WD-0009 TO 0020.
04. JOINERY / STRUCTURAL GLAZING SHOWN IN PLAN ARE INDICATIVE. REFER HARDWARE SCHEDULE TEMPLATE FOR DETAILS.
05. FOR JOINERY, STAIRCASE, RAMP DETAILS, LIFTS, TOILETS, WALL SECTIONS, FLOORING PATTERN DETAILS, FURNITURE LAYOUTS & FALSE CEILING DETAILS REFER SEPARATE DRAWINGS.
06. FOR STRUCTURAL, PUBLIC HEALTH ENGINEERING, HVAC, ELECTRICAL, AND FIRE FIGHTING DETAILS REFER APPROPRIATE SEPARATE DRAWINGS.
07. AHU PEDESTAL DETAIL REFER STRUCTURAL DRAWING.
08. ALL EXTERNAL WALLS SHOULD BE BUILT UPTO SOFFIT OF BEAM OR CEILING.

WALL LEGEND :

1. 250MM THK BLOCK WORK UP TO SOFFIT OF SLAB / BEAM
2. 230MM THK BRICK WORK UP TO SOFFIT OF SLAB / BEAM
3. 150MM THK BLOCK WORK UP TO SOFFIT OF SLAB / BEAM
4. 125MM THK BLOCK WORK 2800MM HIGH FROM FFL
5. 125MM THK BLOCK WORK 2100MM HIGH FROM FFL
6. 125MM THK BLOCK WORK 2800MM HIGH AND DRY WALL PARTITION ABOVE UP TO SOFFIT OF SLAB / BEAM
7. 100MM THK DRY WALL PARTITION UP TO SOFFIT OF SLAB / BEAM
8. 100MM THK DRY WALL PARTITION TILL 100MM ABOVE FALSE CEILING

LEGEND :

FFL	FINISHED ROAD LEVEL	AHU	AIR HANDLING UNIT
FGL	FORMED GROUND LEVEL	LD	LEAD LINED DOOR
FFL	FINISHED FLOOR LEVEL	AL	ALUMINUM LOUVER
FEA	FIRE EQUIPMENT AREA	AW	ALUMINUM WINDOW
TOC	TOP OF CONCRETE	AD	ALUMINUM DOOR
LVL	LEVEL	WD	WOODEN DOOR
TOI.	TOILET	FD	FIRE DOOR
ELV	EXTRA LOW VOLTAGE	P.TOI.	PATIENT TOILET

SHAFT SCHEDULE -THIRD FLOOR

TAG	DESCRIPTION	LENGTH	WIDTH
03-SH-100	PHE SHAFT	600	1400
03-SH-101	PHE SHAFT	600	1225
03-SH-102	PHE SHAFT	800	2075
03-SH-103	PHE SHAFT	600	1400
03-SH-104	PHE SHAFT	600	1025
03-SH-105	PHE SHAFT	650	600
03-SH-106	PHE SHAFT	250	875
03-SH-108	PHE SHAFT	650	600
03-SH-109	PHE SHAFT	600	600
03-SH-200	HVAC SHAFT	600	1200
03-SH-201	HVAC SHAFT	800	1775
03-SH-202	HVAC SHAFT	800	1300
03-SH-203	HVAC SHAFT	800	1425

DOOR SCHEDULE - THIRD FLOOR

TAG	WIDTH	HEIGHT	COUNT
AD14sr	2000	2400	1
AD15p	1800	2100	7
AD16p	1500	2100	10
FD01	2000	2100	4
FD01a	2150	2100	4
FD07	1200	2100	4
FD12	1800	2100	3
SD10v	750	2000	3
SD11a	600	1500	10
WD09a	1500	2100	16
WD12	900	2100	4
WD12L	900	2100	1
WD12r	900	2100	3

WINDOW / LOUVER SCHEDULE - THIRD FLOOR

TAG	WIDTH	HEIGHT	COUNT
AW02a	1200	450	1
AW03	1500	600	4
AW01	1800	1500	17
AW01L	1800	1500	6
AW02	1500	1500	6
AW03	1200	1500	2
EAL10	400	150	2
FAL08	1500	600	1
SVL01	900	300	6