This drawing is the property of L&T Construction, B&F-EDRC and must not be passed on to any person or body not authorised by us to receive it nor be copied or otherwise made use either in full or in part by such person or body without our prior permission in writing.

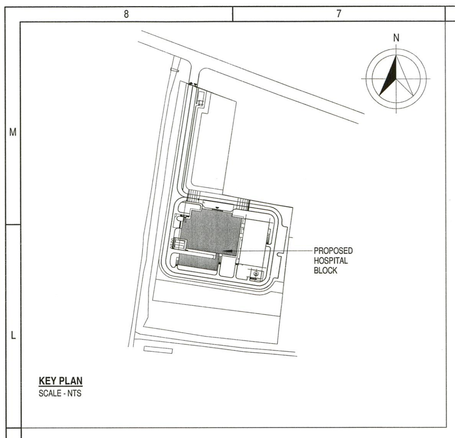

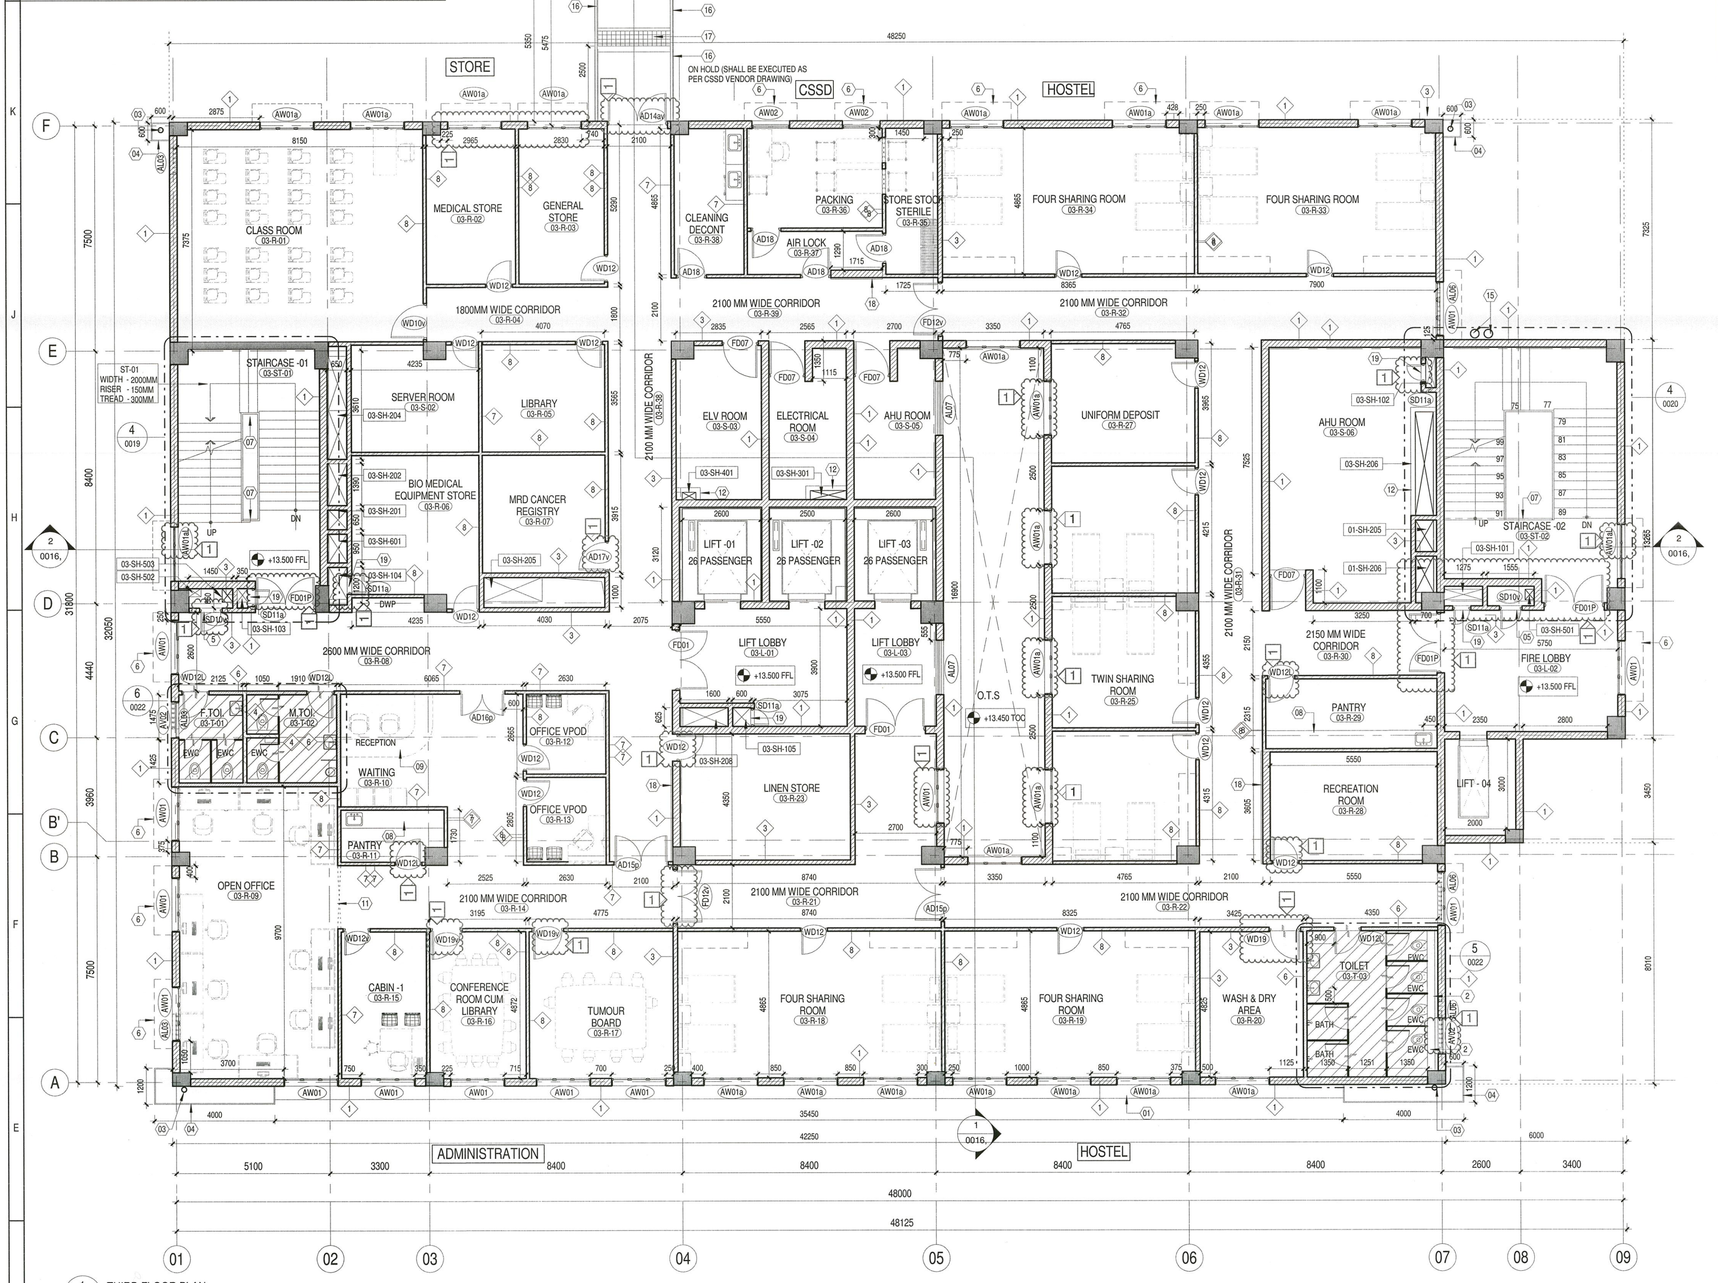

1 / 0012 THIRD FLOOR PLAN
1 : 100

GENERAL NOTES :

01. ALL DIMENSIONS ARE IN MILLIMETERS & LEVELS IN METERS.

02. +0.000FFL REFERS TO +67.900 LEVEL AT SITE.

03. THIS DRAWING SHOULD BE READ IN CONJUNCTION WITH THE ALL FLOOR PLANS, ELEVATIONS & SECTIONS O19035-A-HP-06-WD-0009 TO 0016.

04. JOINERY / STRUCTURAL GLAZING SHOWN IN PLAN ARE INDICATIVE, REFER HARDWARE SCHEDULE TEMPLATE FOR DETAILS.

05. FOR JOINERY, STAIRCASE, RAMP DETAILS, LIFTS, TOILETS, WALL SECTIONS, FLOORING PATTERN DETAILS, FURNITURE LAYOUTS & FALSE CEILING DETAILS REFER SEPARATE DRAWINGS.

06. FOR STRUCTURAL, PUBLIC HEALTH ENGINEERING, HVAC, ELECTRICAL, AND FIRE FIGHTING DETAILS REFER APPROPRIATE SEPARATE DRAWINGS.

07. AHU PEDESTAL DETAIL REFER MEP DRAWING.

08. ALL EXTERNAL WALLS SHOULD BE BUILT UPTO SOFFIT OF BEAM OR CEILING.

09. LIFT WALL OPENING SIZES AND POSITIONING AS PER LIFT MANUFACTURER'S SPECIFICATION AND TO BE FOLLOWED AS PER THE APPROVED VENDOR DWG.

10. FOR TOILET DETAILS REFER STANDARD DRAWING.

11. ALL ROOF SLAB CUTOUTS INDICATED IN THIS DRAWING ARE TENTATIVE. REFER MEP & STRUCTURAL DRAWINGS FOR EXACT LOCATION.

12. ALL DIMENSIONS SHALL BE VERIFIED ON SITE PRIOR TO START OF WORK AND ANY DISCREPANCY SHALL BE BROUGHT TO THE NOTICE OF THE ARCHITECT AT EDRC.

13. ANY DISCREPANCY NOTICED SHALL BE BROUGHT TO THE ATTENTION OF THE CONSULTANTS WITH IN 7 WORKING DAYS OF RECEIVING THE DRAWING, PRIOR TO PROCUREMENT / EXECUTION OF WORK.

14. THE FURNITURE SHOWN IN THE DRAWING ARE INDICATIVE AND IS NOT IN L&T SCOPE OF WORK.

NOTE :

*** ALL PARTITION SIZES SHALL BE AS PER FINALIZED VENDER DETAILS.**

KEY NOTES :

1. RC SLAB PROJECTION TO SUPPORT ACP CLADDING.
2. 200MM THICK WET TO WET PARTITION LEDGE WALL UP TO 1200MM HIGH WITH WET TO WET PARTITION LEDGE COVER ON TOP.
3. RAIN WATER DOWN TAKE PIPE.
4. ACP CLADDING.
5. FEA SHAFT DOOR 100MM SILL FROM FINISH FLOOR LEVEL
6. 600MM WIDE SUNSHADE ABOVE.
7. M.S.HANDRAIL TO DETAIL.
8. COUNTER TO DETAIL
9. RECEPTION / NURSING TABLE.
10. 10MM DROP FROM FINISH FLOOR LEVEL.
11. 2100x2100MM WALL OPENING FROM FFL.
12. 150MM THICK 150MM HIGH KERB WALL.
13. REFER STANDARD DRAWINGS FOR TOILET DETAILS
14. REFER SEPARATE DRAWING FOR RAMP AND CONNECTING CORRIDOR DETAIL
15. DG EXHAUST VENT PIPE.
16. RC PARAPET WALL FOR RAMP REFER STRUCTURAL DRAWING.
17. EXPANSION JOINT DETAILS REFER STRUCTURAL DRAWING.
18. DB LOCATION IN PLAN.
19. PHE SHAFT DOOR 300MM SILL FROM FINISH FLOOR LEVEL

CLIENT SIGNATURE :

REVISION HISTORY:1

REFER O19035-A-HP-CE-0011 FOR CHANGES TO ALIGN AS PER INTERIOR SCHEMES AND CHANGES AS PER CLIENT REQUIREMENTS IN HOSPITAL BLOCK. OTHER CHANGES IN HVAC LOUVERS.

BED SUMMARY :

Sl.No.	DESCRIPTION	BED QTY
1.	TWIN SHARING ROOM	6 NOS
2.	FOUR SHARING ROOM	16 NOS

WINDOW / LOUVER SCHEDULE - THIRD FLOOR

TAG	WIDTH	HEIGHT	SILL HEIGHT	COUNT
AL03	900	300	2500	3
AL06	1800	300	2500	3
AL07	1800	1500	900	2
AV02	1200	600	1800	2
AW01	1800	1500	900	13
AW01a	1800	1500	900	21
AW01aL	1800	1500	900	2
AW02	1250	1500	900	2

SUNKEN LEGEND:

FLOOR SLAB TO BE SUNKEN BY 100MM

CUTOUT LEGEND:

FLOOR CUTOUT

ROOF CUTOUT

FLOOR LEVEL — 00-0-XXX — ROOM SERIAL NO. / ROOM TYPE

ROOM TAG KEYNOTE:

S - SERVICES
T - TOILET
L - LIFT LOBBY
ST - STAIRCASE
R - ROOMS

FLOOR LEVEL — 00-SH-XXX — SHAFT TYPE / SERIAL NO. / SHAFT

SHAFT NO	SHAFT TYPE
1XX	PHE
2XX	HVAC
3XX	ELECTRICAL
4XX	ELV
5XX	FEA
6XX	MGPS

REV.NO.	DESCRIPTION	DESIGNED	DRAWN	CHECKED	APPROVED
1	REVISED AND RELEASED AS GOOD FOR CONSTRUCTION	ARKH 21.12.2020	MG 22.12.2020	TI 25.03.2021	JA 25.03.2021
0	RELEASED AS GOOD FOR CONSTRUCTION	ARKH ARKH 11.10.19	MG MG 11.10.19	TI TI 14.10.19	JA JA 14.10.19

REVISIONS

CHECKED BY	SIGN	DATE	CHECKED BY	SIGN	DATE	CHECKED BY	SIGN	DATE
ARCHITECTURE			HVAC			GIS		
CIVIL & STRUCTURAL			FPS			GEOTECH		
ELECTRICAL			PIPING			VHT		
ELV SYSTEM			PHE					

CLIENT : ASSAM CANCER CARE FOUNDATION

A ASSAMCANCERCARE.ORG A CONSTRUCTION OF AFFORDABLE CANCER CARE

L&T Construction — Buildings & Factories

PROJECT : Proposed Cancer Centre At 18 Locations In Assam For Assam Cancer Care Foundation & M/s. Tata Trusts

TEZPUR CANCER CENTRE
(A Government of Assam and Tata Trusts Initiative).

CONSULTANT: Engineering Design and Research Center (EDRC), L&T Construction - Buildings & Factories.

CONCEPT ARCHITECT: Engineering Design and Research Center (EDRC), L&T Construction - Buildings & Factories.

SUPPLIER / CONTRACTOR : Larsen & Toubro Limited, Construction, Buildings & Factories

JOB No : O19035

	NAME	SIGN	DATE
DSGN	ARKH	ARKH	11.10.19
DRWN	MG	MG	11.10.19
CHKD	TI	TI	14.10.19
APPD	JA	JA	14.10.19

TITLE:

TEZPUR - HOSPITAL BLOCK

THIRD FLOOR PLAN

SECTION/ ELEVATION MARKING — DRAWING NUMBER

SCALE: As indicated

DRAWING No. O19035 - A - HP - 06 - WD - 0012

SHEET:

PROJECTION: FIRST ANGLE

SIZE	REV
A1	1

RELEASED FOR: ☐ PRELIMINARY ☑ TENDER ☐ INFORMATION ☐ APPROVAL ☐ CONSTRUCTION

WALL LEGEND :

1. 250MM THK. BLOCK WORK UP TO SOFFIT OF THE SLAB/BEAM.
2. 230MM THK. BRICK WORK UP TO SOFFIT OF THE SLAB/BEAM.
3. 150MM THK BLOCK WORK UP TO SOFFIT OF THE SLAB/BEAM.
4. 125MM THK BLOCK WORK 2800MM HIGH FROM FFL.
5. 125MM THK BLOCK WORK 2100MM HIGH FROM FFL.
6. 125MM THK. BLOCK WORK 2800MM HIGH AND DRY WALL PARTITION ABOVE UPTO SOFFIT OF THE SLAB/BEAM.
7. 109 mm THK DRY WALL UP TO SOFFIT OF THE SLAB/BEAM.
8. 109MM THK DRY WALL PARTITION TILL 100MM ABOVE FALSE CEILING.
9. 109MM THK DRY WALL PARTITION 2100MM HIGH FROM FFL.

TOILET WC LEDGE WALLS 900MM HIGH & URINAL LEDGE WALLS 1200MM HIGH FROM FFL.

LEGEND :

FFL	FINISHED FLOOR LEVEL	AD	ALUMINIUM DOOR
FEA	FIRE EQUIPMENT AREA	WD	WOODEN DOOR
ELV	EXTRA LOW VOLTAGE	FD	FIRE DOOR
PHE	PUBLIC HEALTH ENGINEERING	N.S	NURSES STATION
		TOI.	TOILET
HVAC	HEATING VENTILATION AIR CONDITIONING	F.TOI.	FEMALE TOILET
AHU	AIR HANDLING UNIT	M.TOI.	MALE TOILET
LD	LEAD LINED DOOR	CSSD	CENTRAL STERILE SERVICES DEPARTMENT
LW	LEAD LINED WINDOW		
AL	ALUMINIUM LOUVER		
AW	ALUMINIUM WINDOW		

SHAFT SCHEDULE -THIRD FLOOR

TAG	DESCRIPTION	LENGTH	WIDTH
03-SH-101	PHE SHAFT	1275	350
03-SH-102	PHE SHAFT	300	1000
03-SH-103	PHE SHAFT	352	450
03-SH-104	PHE SHAFT	600	1065
03-SH-105	PHE SHAFT	625	600
03-SH-201	HVAC SHAFT	600	650
03-SH-202	HVAC SHAFT	600	1380
03-SH-203	HVAC SHAFT	600	1800
03-SH-204	HVAC SHAFT	600	1625
03-SH-205	HVAC SHAFT	600	1050
03-SH-205	HVAC SHAFT	1940	800
03-SH-206	HVAC SHAFT	600	3450
03-SH-206	HVAC SHAFT	600	1200
03-SH-208	HVAC SHAFT	625	1500
03-SH-301	ELECTRICAL SHAFT	300	1200
03-SH-401	ELV SHAFT	450	250
03-SH-501	FPS SHAFT	300	350
03-SH-502	FPS SHAFT	400	270
03-SH-503	FPS SHAFT	350	450
03-SH-601	MGPS SHAFT	600	935

DOOR SCHEDULE - THIRD FLOOR

TAG	WIDTH	HEIGHT	COUNT
AD14av	2000	2400	1
AD15p	1800	2100	2
AD16p	1500	2100	1
AD17v	1000	2100	1
AD18	1000	2100	4
FD01	2000	2100	2
FD01P	2000	2100	3
FD07	1200	2100	4
FD12v	1800	2100	2
SD10v	750	2000	2
SD11a	600	1500	5
WD10v	1200	2100	1
WD12	900	2100	17
WD12L	900	2100	5
WD12v	900	2100	1
WD19	1050	2100	1
WD19v	1050	2100	2