This drawing is the property of L&T Construction, B&F-EDRC and must not be passed on to any person or body not authorised by us to receive it nor be copied or otherwise made use either in full or in part by such person or body without our prior permission in writing.

NORTH POINT:

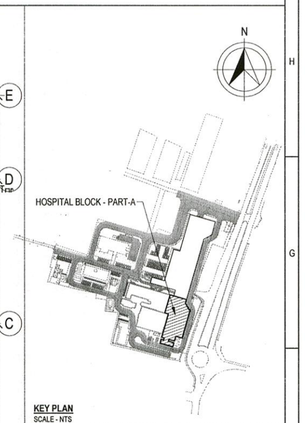

KEY PLAN
SCALE - NTS

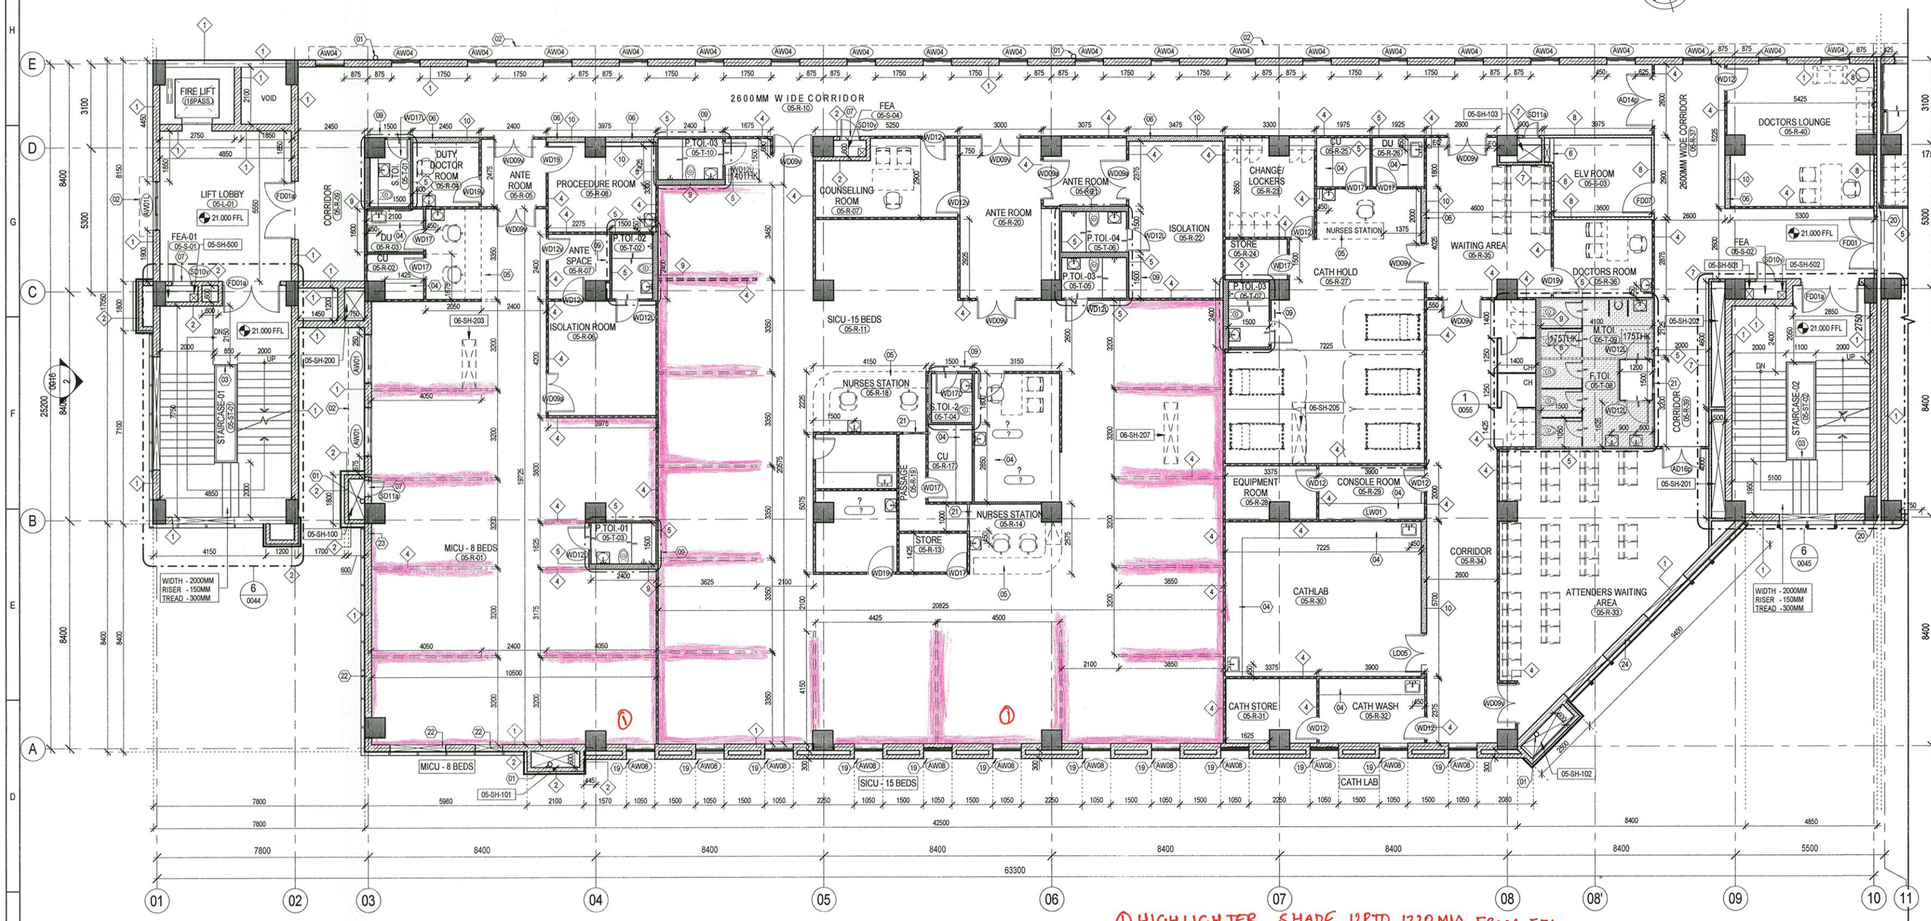

1 / 0031 FIFTH FLOOR - PART-A
1 : 100

NOTE:
ALL WALLS MAIN COLOUR SHALL BE BERGER FROZEN ICE (4P18499)
HIGHLIGHTER SHADE SHALL BE SILK RIBBON (T2466)

① HIGHLIGHTER SHADE UPTO 1220 MM FROM FFL

GENERAL NOTES :

01. ALL DIMENSIONS ARE IN MILLIMETERS & LEVELS IN METERS.
02. +0.000FFL REFERS TO 21.400 LEVEL AT SITE.
03. THIS DRAWING SHOULD BE READ IN CONJUNCTION WITH THE ALL FLOOR PLANS, ELEVATIONS & SECTIONS O19035-A-HP-02-WD-0020 TO 0042.
04. JOINERY / STRUCTURAL GLAZING SHOWN IN PLAN ARE INDICATIVE, REFER HARDWARE SCHEDULE TEMPLATE FOR DETAILS.
05. FOR JOINERY, STAIRCASE, RAMP DETAILS, LIFTS, TOILETS, WALL SECTIONS, FLOORING PATTERN DETAILS, FURNITURE LAYOUTS & FALSE CEILING DETAILS REFER SEPARATE DRAWINGS.
06. FOR STRUCTURAL, PUBLIC HEALTH ENGINEERING, HVAC, ELECTRICAL, AND FIRE FIGHTING DETAILS REFER APPROPRIATE SEPARATE DRAWINGS.
07. AHU PEDESTAL DETAIL REFER STRUCTURAL DRAWING.
08. ALL EXTERNAL WALLS SHOULD BE BUILT UPTO SOFFIT OF BEAM OR CEILING.
09. LIFT WALL OPENING SIZES AND POSITIONING AS PER LIFT MANUFACTURER'S SPECIFICATION AND TO BE FOLLOWED AS PER THE APPROVED VENDOR DWG.
10. FOR TOILET DETAILS REFER STANDARD DRAWING.
11. FOR KITCHEN DETAILS REFER SEPARATE DRAWINGS.
12. ALL ROOF SLAB CUTOUTS INDICATED IN THIS DRAWING ARE TENTATIVE. REFER STRUCTURAL DRAWINGS FOR EXACT LOCATION.
13. ALL DIMENSIONS SHALL BE VERIFIED ON SITE PRIOR TO START OF WORK AND ANY DISCREPANCY SHALL BE BROUGHT TO THE NOTICE OF THE ARCHITECT AT EDRC.
14. ANY DISCREPANCY NOTICED SHALL BE BROUGHT TO THE ATTENTION OF THE CONSULTANTS WITHIN 7 WORKING DAYS OF RECEIVING THE DRAWING, PRIOR TO PROCUREMENT / EXECUTION OF WORK.
15. THE FURNITURE SHOWN IN THE DRAWING ARE INDICATIVE AND IS NOT IN L & T SCOPE OF WORK.
16. 100MM THK. WALL SHOULDER HAS TO BE MAINTAINED FOR ALL DOORS AND 200MM THK WALL SHOULDER AT COLUMN LOCATION OR UNLESS SPECIFIED.

WALL HATCH LEGEND:

- 250 / 150MM THK BLOCK WALL
- PROP.WALL / COLUMN
- EXISTING COLUMN

SUNKEN LEGEND:

- 100MM FLOOR SLAB TO BE SUNKEN FROM TOC
- 300MM FLOOR SLAB TO BE SUNKEN FROM TOC

WINDOW / VENTILATOR SCHEDULE - FIFTH...

TAG	WIDTH	HEIGHT	COUNT
AW01	1800	1550	2
AW01L	1800	1550	1
AW04	1050	2250	21
AW08	1050	2000	12
LW01	1200	1200	1

FLOOR LEVEL — ROOM SERIAL NO. (00-0-XXX) — ROOM TYPE

ROOM TAG KEYNOTE:

S - SERVICES
T - TOILET
L - LIFT LOBBY
ST - STAIRCASE
R - ROOMS

FLOOR LEVEL — SHAFT TYPE / SERIAL NO. (00-SH-XXX) — SHAFT

SHAFT NO	SHAFT TYPE
1XX	PHE
2XX	HVAC
3XX	ELECTRICAL
4XX	ELV
5XX	FEA
6XX	MGPS

CUTOUT LEGEND:

- FLOOR CUTOUT
- ROOF CUTOUT

DOOR SCHEDULE - FIFTH FLOOR PART-A

TAG	WIDTH	HEIGHT	COUNT
AD14p	2000	2100	1
AD16p	1500	2100	1
FD01	2000	2100	1
FD01a	2150	2100	3
FD07	1200	2100	1
LD05	1500	2100	1
SD10v	750	2000	3
SD11a	600	1500	2
WD09a	1500	2100	3
WD09v	1500	2100	9
WD12	900	2100	6
WD12L	900	2100	8
WD12v	900	2100	4
WD17	850	2100	7
WD17L	850	2100	2
WD19	1050	2100	1
WD19v	1050	2100	3
			56

SHAFT SCHEDULE - FIFTH FLOOR-PART-A

TAG	DESCRIPTION	LENGTH	WIDTH
05-SH-100	PHE SHAFT	1500	600
05-SH-101	PHE SHAFT	1800	600
05-SH-102	PHE SHAFT	2100	600
05-SH-103	PHE SHAFT	600	900
05-SH-105	PHE SHAFT	1700	1100
05-SH-200	HVAC SHAFT	750	1100
05-SH-201	HVAC SHAFT	500	3700
05-SH-202	HVAC SHAFT	500	4350
05-SH-211	HVAC SHAFT	1600	950
05-SH-212	HVAC SHAFT	1600	1400
05-SH-213a	HVAC SHAFT	1650	1400
05-SH-213b	HVAC SHAFT	1400	1400
05-SH-214	HVAC SHAFT	1500	1400
05-SH-400	ELV SHAFT	200	600
05-SH-500	FPS SHAFT	300	300
05-SH-501	FPS SHAFT	400	300
05-SH-502	FPS SHAFT	300	300
05-SH-506	FPS SHAFT	300	300
05-SH-507	FPS SHAFT	300	300
05-SH-600	MGPS SHAFT	1150	950

KEY NOTES :

1. RAIN WATER DOWN TAKE PIPE.
2. 500MM WIDE SUNSHADE ABOVE.
3. M.S.HANDRAIL TO DETAIL.
4. COUNTER TO DETAIL.
5. RECEPTION / NURSING TABLE.
6. DB LOCATION.
7. FEA / PHESHAFT DOOR 100MM SILL FROM FINISH FLOOR LEVEL
8. MGPS SHAFT DOOR 300MM SILL FROM FINISH FLOOR LEVEL.
9. REFER STANDARD FOR TOILET DETAILS
10. 1000x1500MM WALL OPENING ABOVE COUNTER.
11. RC PARAPET WALL.
12. RC BEAM SEEN IN PLAN.
13. STONE CLADDING REFER SEPARATE DRAWING.
14. SPACE FOR ELETRICAL PANEL.
15. 150MM THK. 1200MM HIGH LEDGE WALL.
16. 200MM THK. 1200MM HIGH LEDGE WALL.
17. 1500x1500MM WALL OPENING AT SILL 900MM FROM FFL.
18. EXHAUST LOUVER FOR REFER HVAC DRAWINGS.
19. LINTEL SLAB PROJECTION AT 3000MM FROM FFL.
20. EXPANSION JOINT REFER STRUCTURAL DRG.
21. 1000x2100MM WALL OPENING FROM FFL.
22. 1000x1500MM WALL OPENING AT SILL 1300MM FROM FFL.
23. 820x1500MM WALL OPENING AT SILL 1300MM FROM FFL.
24. 5200x1500MM WALL OPENING AT SILL 1050MM FROM FFL.

WALL LEGEND :

1. 250MM THK. BLOCK WALLS UP TO SOFFIT OF THE SLAB/BEAM.
2. 150MM THK. BLOCK WALLS UP TO SOFFIT OF THE SLAB/BEAM .
3. 230MM THK BRICK WORK UP TO SOFFIT OF THE SLAB/BEAM.
4. 75MM THK. DRY TO DRY WALL PARTITION From TOC to 100mm High TOP OF THE FALSE CEILING ★
5. 75MM THK. DRY TO WET WALL PARTITION From TOC to 100mm High TOP OF THE FALSE CEILING ★
6. 75MM THK. WET TO WET WALL PARTITION From TOC to 100mm High TOP OF THE FALSE CEILING ★
7. 100MM THK. DRY TO DRY WALL PARTITION (SHAFT) UP TO SOFFIT OF THE SLAB/BEAM. ★
8. 100MM THK. DRY TO DRY WALL PARTITION (FIRE RATED) UP TO SOFFIT OF THE SLAB/BEAM. ★
9. 200MM THK. DRY TO WET WALL PARTITION (FOR TOILET) UP TO SOFFIT OF THE SLAB/BEAM. ★
10. 200MM THK. DRY TO DRY WALL PARTITION (FOR DB) UP TO SOFFIT OF THE SLAB/BEAM. ★
11. 200MM THK. WET TO WET WALL PARTITION (FOR TOILET) UP TO SOFFIT OF THE SLAB/BEAM. ★
12. 200MM THK. DRY TO DRY WALL PARTITION (FOR FIRE RATED) UP TO SOFFIT OF THE SLAB/BEAM. ★
13. 100MM THK. DRY TO WET WALL PARTITION (FOR TOILET) UP TO SOFFIT OF THE SLAB/BEAM. ★
14. 300MM THK. DRY TO WET WALL PARTITION (FOR TOILET LEDGE WALL) UP TO 1200MM HIGH ★
15. 250MM THK. DRY TO DRY WALL PARTITION UP TO SOFFIT OF THE SLAB/BEAM ★

NOTE :

*ALL PARTITION SIZES SHALL BE AS PER FINALIZED VENDER DETAILS.
- FOR DETAIL ELEVATED ROAD REFER SEPARATE ARCHITECTURE AND STRUCTURAL DRAWINGS.

LEGEND :

FFL	- FINISHED FLOOR LEVEL
FEA	- FIRE EQUIPMENT AREA
LVL	- LEVEL
TOI.	- TOILET
ELV	- EXTRA LOW VOLTAGE
PHE	- PUBLIC HEALTH ENGINEERING
HVAC	- HEATING VENTILATION AIR CONDITIONING
AHU	- AIR HANDLING UNIT
AL	- ALUMINIUM LOUVER
AW	- ALUMINIUM WINDOW
AD	- ALUMINIUM DOOR
WD	- WOODEN DOOR
FD	- FIRE DOOR
SD	- STEEL DOOR
CU	- CLEAN UTILITY
DU	- DIRTY UTILITY
P.TOI.	- PATIENT TOILET
S.TOI.	- STAFF TOILET
M.TOI.	- MALE TOILET
F.TOI.	- FEMALE TOILET
MICU	- MEDICAL INTENSIVE CARE UNIT
SICU	- SURGICAL INTENSIVE CARE UNIT
~	- 10MM DROP FROM FINISH FLOOR LEVEL

CLIENT SIGNATURE :

REV.NO.	DESCRIPTION	DESIGNED	DRAWN	CHECKED	APPROVED
0	RELEASED AS GOOD FOR CONSTRUCTION	ARKH 24.01.2020	MG 24.01.2020	TI 25.02.2020	JA 25.02.2020

REVISIONS

CHECKED BY	SIGN	DATE	CHECKED BY	SIGN	DATE	CHECKED BY	SIGN	DATE
ARCHITECTURE			HVAC			GIS		
CIVIL & STRUCTURAL			FPS			GEOTECH		
ELECTRICAL			PIPING			VHT		
ELV SYSTEM			PHE					

CLIENT : ASSAM CANCER CARE FOUNDATION

L&T Construction — Buildings & Factories

PROJECT : Proposed Cancer Centre At 18 Locations In Assam For Assam Cancer Care Foundation & M/s. Tata Trusts
STATE CANCER INSTITUTE , GUWAHATI - PHASE-2 (A Government of Assam and Tata Trusts Initiative)

CONSULTANT: Engineering Design and Research Center (EDRC), L&T Construction - Buildings & Factories.

CONCEPT ARCHITECT: Engineering Design and Research Center (EDRC), L&T Construction - Buildings & Factories.

SUPPLIER / CONTRACTOR : Larsen & Toubro Limited, Construction, Buildings & Factories

JOB No : O19035

TITLE: HOSPITAL BLOCK
FIFTH FLOOR PLAN - PART-A

	NAME	SIGN	DATE
DSGN	ARKH		24.01.2020
DRWN	MG		24.01.2020
CHKD	TI		25.02.2020
APPD	JA		25.02.2020

SECTION/ ELEVATION MARKING — DRAWING NUMBER

SCALE: As indicated

DRAWING No. O19035 - A - HP - 02 - WD - 0031

SHEET:

PROJECTION: FIRST ANGLE

SIZE: A1 | REV: 0

RELEASED FOR: ☐ PRELIMINARY ☐ TENDER ☐ INFORMATION ☐ APPROVAL ☑ CONSTRUCTION