This drawing is the property of L&T Construction, B&F-EDRC and must not be passed on to any person or body not authorised by us to receive it nor be copied or otherwise made use either in full or in part by such person or body without our prior permission in writing.

NORTH POINT:

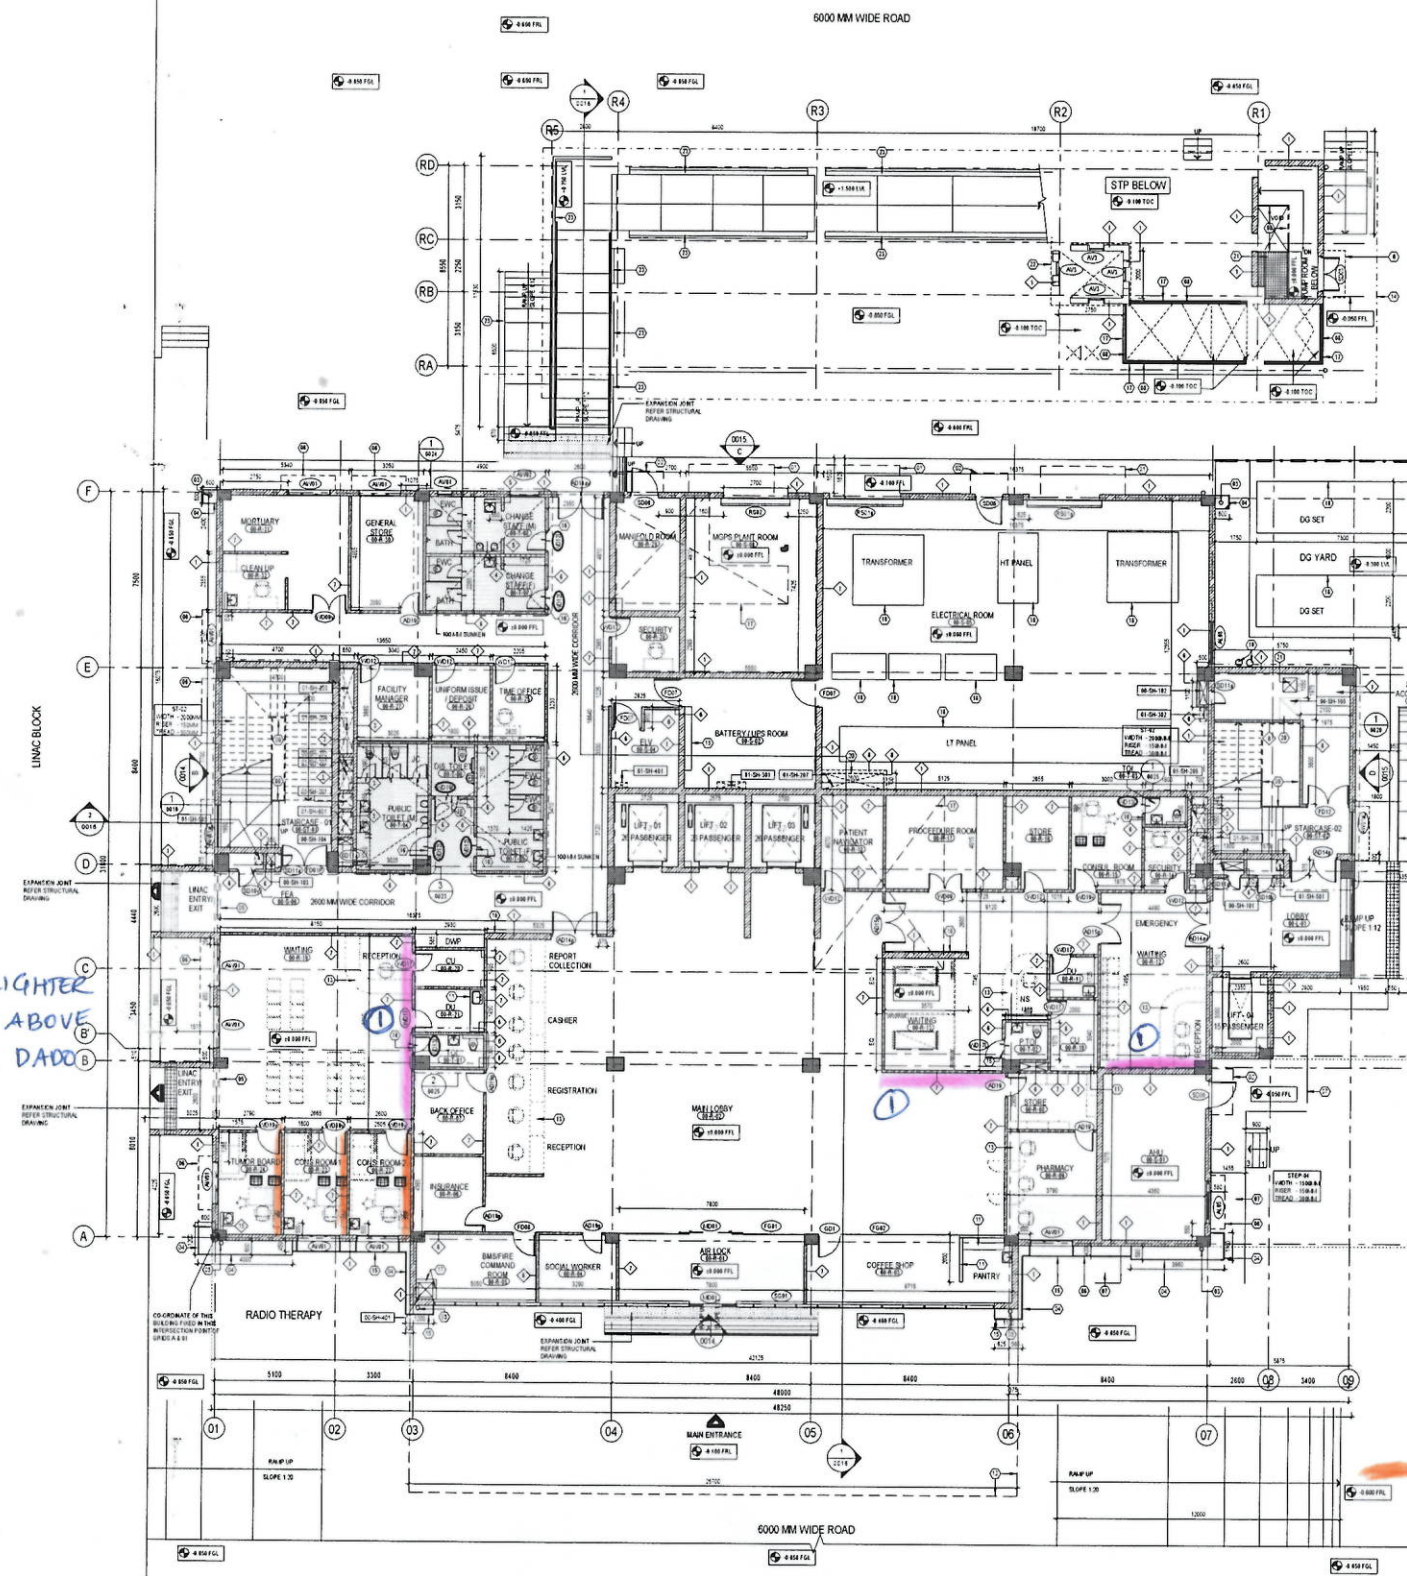

1 GROUND FLOOR PLAN
0009 1 100

NOTE:
ALL WALLS MAIN COLOUR SHALL BE BERGER FROZEN ICE (4P1849)
HIGHLIGHTER PAINT SHADE ~~SMOKE~~ DIAMANTE (8T1723)
HIGHLIGHTER PAINT SHADE SILK RIBBON (7T2466)

GENERAL NOTES:

01 ALL DIMENSIONS ARE IN MILLIMETERS & LEVELS IN METERS

02 +0.000(FFL REFERS TO +67.900 LEVEL AT SITE

03 THIS DRAWING SHOULD BE READ IN CONJUNCTION WITH THE ALL FLOOR PLANS, ELEVATIONS & SECTIONS O19035-A HP-06-WD-0008 TO 0010.

04 JOINERY / STRUCTURAL GLAZING SHOWN IN PLAN ARE INDICATIVE. REFER HARDWARE SCHEDULE TEMPLATE FOR DETAILS.

05 FOR JOINERY, STAIRCASE, RAMP DETAILS, LIFTS, TOILETS, WALL SECTIONS, FLOORING PATTERN DETAILS, FURNITURE LAYOUTS & FALSE CEILING DETAILS REFER SEPARATE DRAWINGS.

06 FOR STRUCTURAL, PUBLIC HEALTH ENGINEERING, HVAC, ELECTRICAL, AND FIRE FIGHTING DETAILS REFER APPROPRIATE SEPARATE DRAWINGS.

07 AHU PEDESTAL DETAIL REFER MEP DRAWING.

08 ALL EXTERNAL WALLS SHOULD BE BUILT UPTO SOFFIT OF BEAM OR CEILING.

09 LIFT WALL OPENING SIZES AND POSITIONING AS PER LIFT MANUFACTURER'S SPECIFICATION AND TO BE FOLLOWED AS PER THE APPROVED VENDOR D/NG.

10 FOR TOILET DETAILS REFER STANDARD DRAWING.

11 ALL ROOF SLAB CUTOUTS INDICATED IN THIS DRAWING ARE TENTATIVE. REFER MEP & STRUCTURAL DRAWINGS FOR EXACT LOCATION.

12 ALL DIMENSIONS SHALL BE VERIFIED ON SITE PRIOR TO START OF WORK AND ANY DISCREPANCY SHALL BE BROUGHT TO THE NOTICE OF THE ARCHITECT AT EDRC.

13 ANY DISCREPANCY NOTICED SHALL BE BROUGHT TO THE ATTENTION OF THE CONSULTANTS WITHIN 7 WORKING DAYS OF RECEIVING THE DRAWING, PRIOR TO PROCUREMENT / EXECUTION OF WORK.

14 THE FURNITURE SHOWN IN THE DRAWING ARE INDICATIVE AND IS NOT IN L&T SCOPE OF WORK.

KEY NOTES:

1. 1200MM WIDE SUNSHADE ABOVE
2. 900MM WIDE SUNSHADE ABOVE
3. RAIN WATER DOWN TAKE PIPE
4. ACP CLADDING
5. 2600X2100 WALL OPENING
6. 450MM WIDE SUNSHADE ABOVE
7. SLAB PROJECTION REFER STRUCTURAL DRAWING
8. M.S. HANDRAIL TO DETAIL
9. S.S. HANDRAIL TO DETAIL
10. CHAIN LINK FENCE GATE
11. COUNTER TO DETAIL
12. CANOPY ABOVE
13. RECEPTION / NURSING TABLE
14. REFER SEPARATE DRAWING FOR RAMP AND CONNECTING CORRIDOR DETAIL
15. GRANITE CLADDING IN ELEVATION
16. 150MM DROP FROM FINISH FLOOR LEVEL
17. 150 MM THICK 150 MM HIGH KERB WALL
18. DB LOCATION IN PLAN
19. EXHAUST VENT PIPE
20. COLLECTION PIT BELOW
21. MAN HOLE REFER STRUCTURAL DRAWING.
22. 75 MM WIDE SLAB PROJECTION AT 1200MM HIGH FROM FFL ALL AROUND
23. RC PARAPET WALL FOR RAMP REFER STRUCTURAL DRAWING
24. 800 X 2100 MM WALL OPENING

DOOR SCHEDULE - GROUND FLOOR

TAG	WIDTH	HEIGHT	COUNT
AD14a	2500	2400	2
AD14b	2500	2100	2
AD15a	1800	2100	2
AD19	900	2100	3
AD19a	900	2100	3
FD01P	2500	2100	1
FD07	1200	2100	3
FD20	1200	2100	1
FD12	1800	2100	1
GD1	900	2100	1
MD01			5
RD01a	3000	3300	2
RS02	2700	3300	1
SD03	1500	2100	1
SD08	1200	2400	3
SD10c	750	2000	2
SD11a	600	1500	4
WD09	1000	2100	1
WD09H	1500	2100	1
WD17	900	2100	7
WD17L	900	2100	4
WD17S	750	2100	2
WD17T	800	2100	4
WD17L	850	2100	1
WD18	1000	2100	1
WD18H	1050	2100	6

WINDOW / LOUVER SCHEDULE - GROUND FLOOR

TAG	WIDTH	HEIGHT	COUNT
ZZ			84
AL05	1800	300	2
AL08	1800	750	1
AV01	600	600	1
AV2	600	900	1
AV05	600	300	2
AV08	900	300	2
AW01	1800	1500	9
AW01-L	1800	1500	2
AW02	1200	1500	1

CLIENT SIGNATURE :

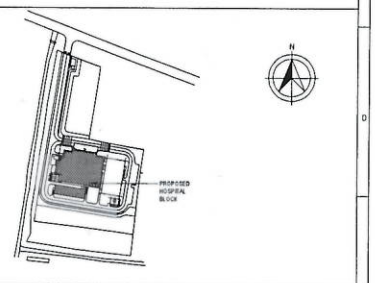

KEY PLAN
SCALE (NTS)

CUTOUT LEGEND:
FLOOR CUTOUT
ROOF CUTOUT

STRUCTURAL GLAZING - GROUND FLOOR

TAG	WIDTH	HEIGHT	COUNT	Area
SG01	4200	4200	1	100 m²

FLOOR LEVEL (00.0xXX) SHAFT TYPE / SERIAL NO SHAFT

SHAFT NO | SHAFT TYPE
XXX | FIRE
XXX | HVAC
XXX | ELECTRICAL
XXX | ELV
XXX | FEA
XXX | MEP

FLOOR LEVEL (00.0XXX) ROOM SERIAL NO ROOM PIPE

ROOM TAG KEYNOTE:
S - SERVICES
T - TOILET
L - LIFT LOBBY
ST - STAIRCASE
R - ROOMS

LEGEND:

FRL	FINISHED ROAD LEVEL	AHU	AIR HANDLING UNIT
FGL	FORMED GROUND LEVEL	LD	LEAD LINED DOOR
FFL	FINISHED FLOOR LEVEL	AL	ALUMINIUM LOUVER
FEA	FIRE EQUIPMENT AREA	AW	ALUMINIUM WINDOW
TOC	TOP OF CONCRETE	AD	ALUMINIUM DOOR
LVL	LEVEL	WD	WOODEN DOOR
TOI	TOILET	FD	FIRE DOOR
ELV	EXTRA LOW VOLTAGE	ACT	ACTIVE
PHE	PUBLIC HEALTH ENGINEERING		
HVAC	HEATING VENTILATION AIR CONDITIONING		

WALL LEGEND:

1. 250MM THK. BLOCK WALLS UP TO SOFFIT OF THE SLAB/BEAM.
2. 150MM THK. BLOCK WALLS UP TO SOFFIT OF THE SLAB/BEAM.
3. 230MM THK BRICK WALL WALLS UP TO SOFFIT OF THE SLAB/BEAM.
4. 100 mm THK DRY TO DRY WALL PARTITION From TOC to 100mm High TOP OF THE FALSE CEILING
5. 100 mm THK DRY TO DRY WALL UP TO SOFFIT OF THE SLAB/BEAM.
6. 125MM THK. BLOCK WALLS UP TO 2.9M ABOVE 100 MM THICK DRY TO DRY WALL PARTITION UPTO SOFFIT OF THE SLAB/BEAM.
7. 125MM THK. BLOCK WALLS UP TO 2.1M ABOVE 100 MM THICK DRY TO DRY WALL PARTITION UPTO SOFFIT OF THE SLAB/BEAM.
8. 125MM THK. 900MM HIGH BLOCK LEDGE WALL

NOTE
* ALL PARTITION SIZES SHALL BE AS PER FINALIZED VENDER DETAILS

SHAFT SCHEDULE - GROUND FLOOR

TAG	DESCRIPTION	LENGTH	WIDTH
00-DA-101	PHE SHAFT	825	350
00-SH-102	PHE SHAFT	300	1050
00-SH-103	PHE SHAFT	350	400
00-SH-104	PHE SHAFT	600	300
00-SH-105	PHE SHAFT	2500	1850
00-SH-202	HVAC SHAFT	600	400
00-SH-401	ELV SHAFT	600	600

SUNKEN LEGEND:
FLOOR SLAB TO BE SUNKEN BY GENERAL SUNKEN

SUNKEN MARKING LEGEND:
ROOF SLAB TO BE SUNKEN

REV NO	DESCRIPTION	DESIGNED	DRAWN	CHECKED	APPROVED
1	REVISED AND RELEASED AS GOOD FOR CONSTRUCTION	ARUN 21.12.2018	SSV 22.12.2018	TI 22.12.2018	JA 25.12.2018
0	RELEASED AS GOOD FOR CONSTRUCTION	ARUN 18.09.2018	SSV 18.09.2018	TI 03.10.2018	JA 04.10.2018

REVISIONS

CHECKED BY	SIGN	DATE	CHECKED BY	SIGN	DATE	CHECKED BY	SIGN	DATE
ARCHITECTURE			HVAC			GIS		
CIVIL & STRUCTURAL			FPS			GEOTECH		
ELECTRICAL			PIPING			VHT		
ELV SYSTEM			PHE					

CLIENT : ASSAM CANCER CARE FOUNDATION

L&T Construction Buildings & Factories

PROJECT : Proposed Cancer Centre At 18 Locations In Assam For Assam Cancer Care Foundation & M/s. Tata Trusts
TEZPUR CANCER CENTRE (A Government of Assam and Tata Trusts Initiative)

CONSULTANT: Engineering Design and Research Center (EDRC), L&T Construction - Buildings & Factories
CONCEPT ARCHITECT: Engineering Design and Research Center (EDRC), L&T Construction - Buildings & Factories

SUPPLIER / CONTRACTOR : Larsen & Toubro Limited, Construction, Buildings & Factories

JOB No : O19035

	NAME	SIGN	DATE
DSGN	ARUN	ARUN	18.09.2018
DRWN	SSV	SSV	18.09.2018
CHKD	TI	TI	03.10.2018
APPD	JA	JA	04.10.2018

TITLE: TEZPUR - HOSPITAL BLOCK
GROUND FLOOR PLAN

SECTION ELEVATION DETAIL NO. DRAWING NUMBER

SCALE: As indicated

DRAWING No. O19035 - A - HP - 06 - WD - 0009

PROJECTION: FIRST ANGLE

SIZE: A0 REV: 1

RELEASED FOR: ☐ PRELIMINARY ☐ TENDER ☐ INFORMATION ☐ APPROVAL ☑ CONSTRUCTION